


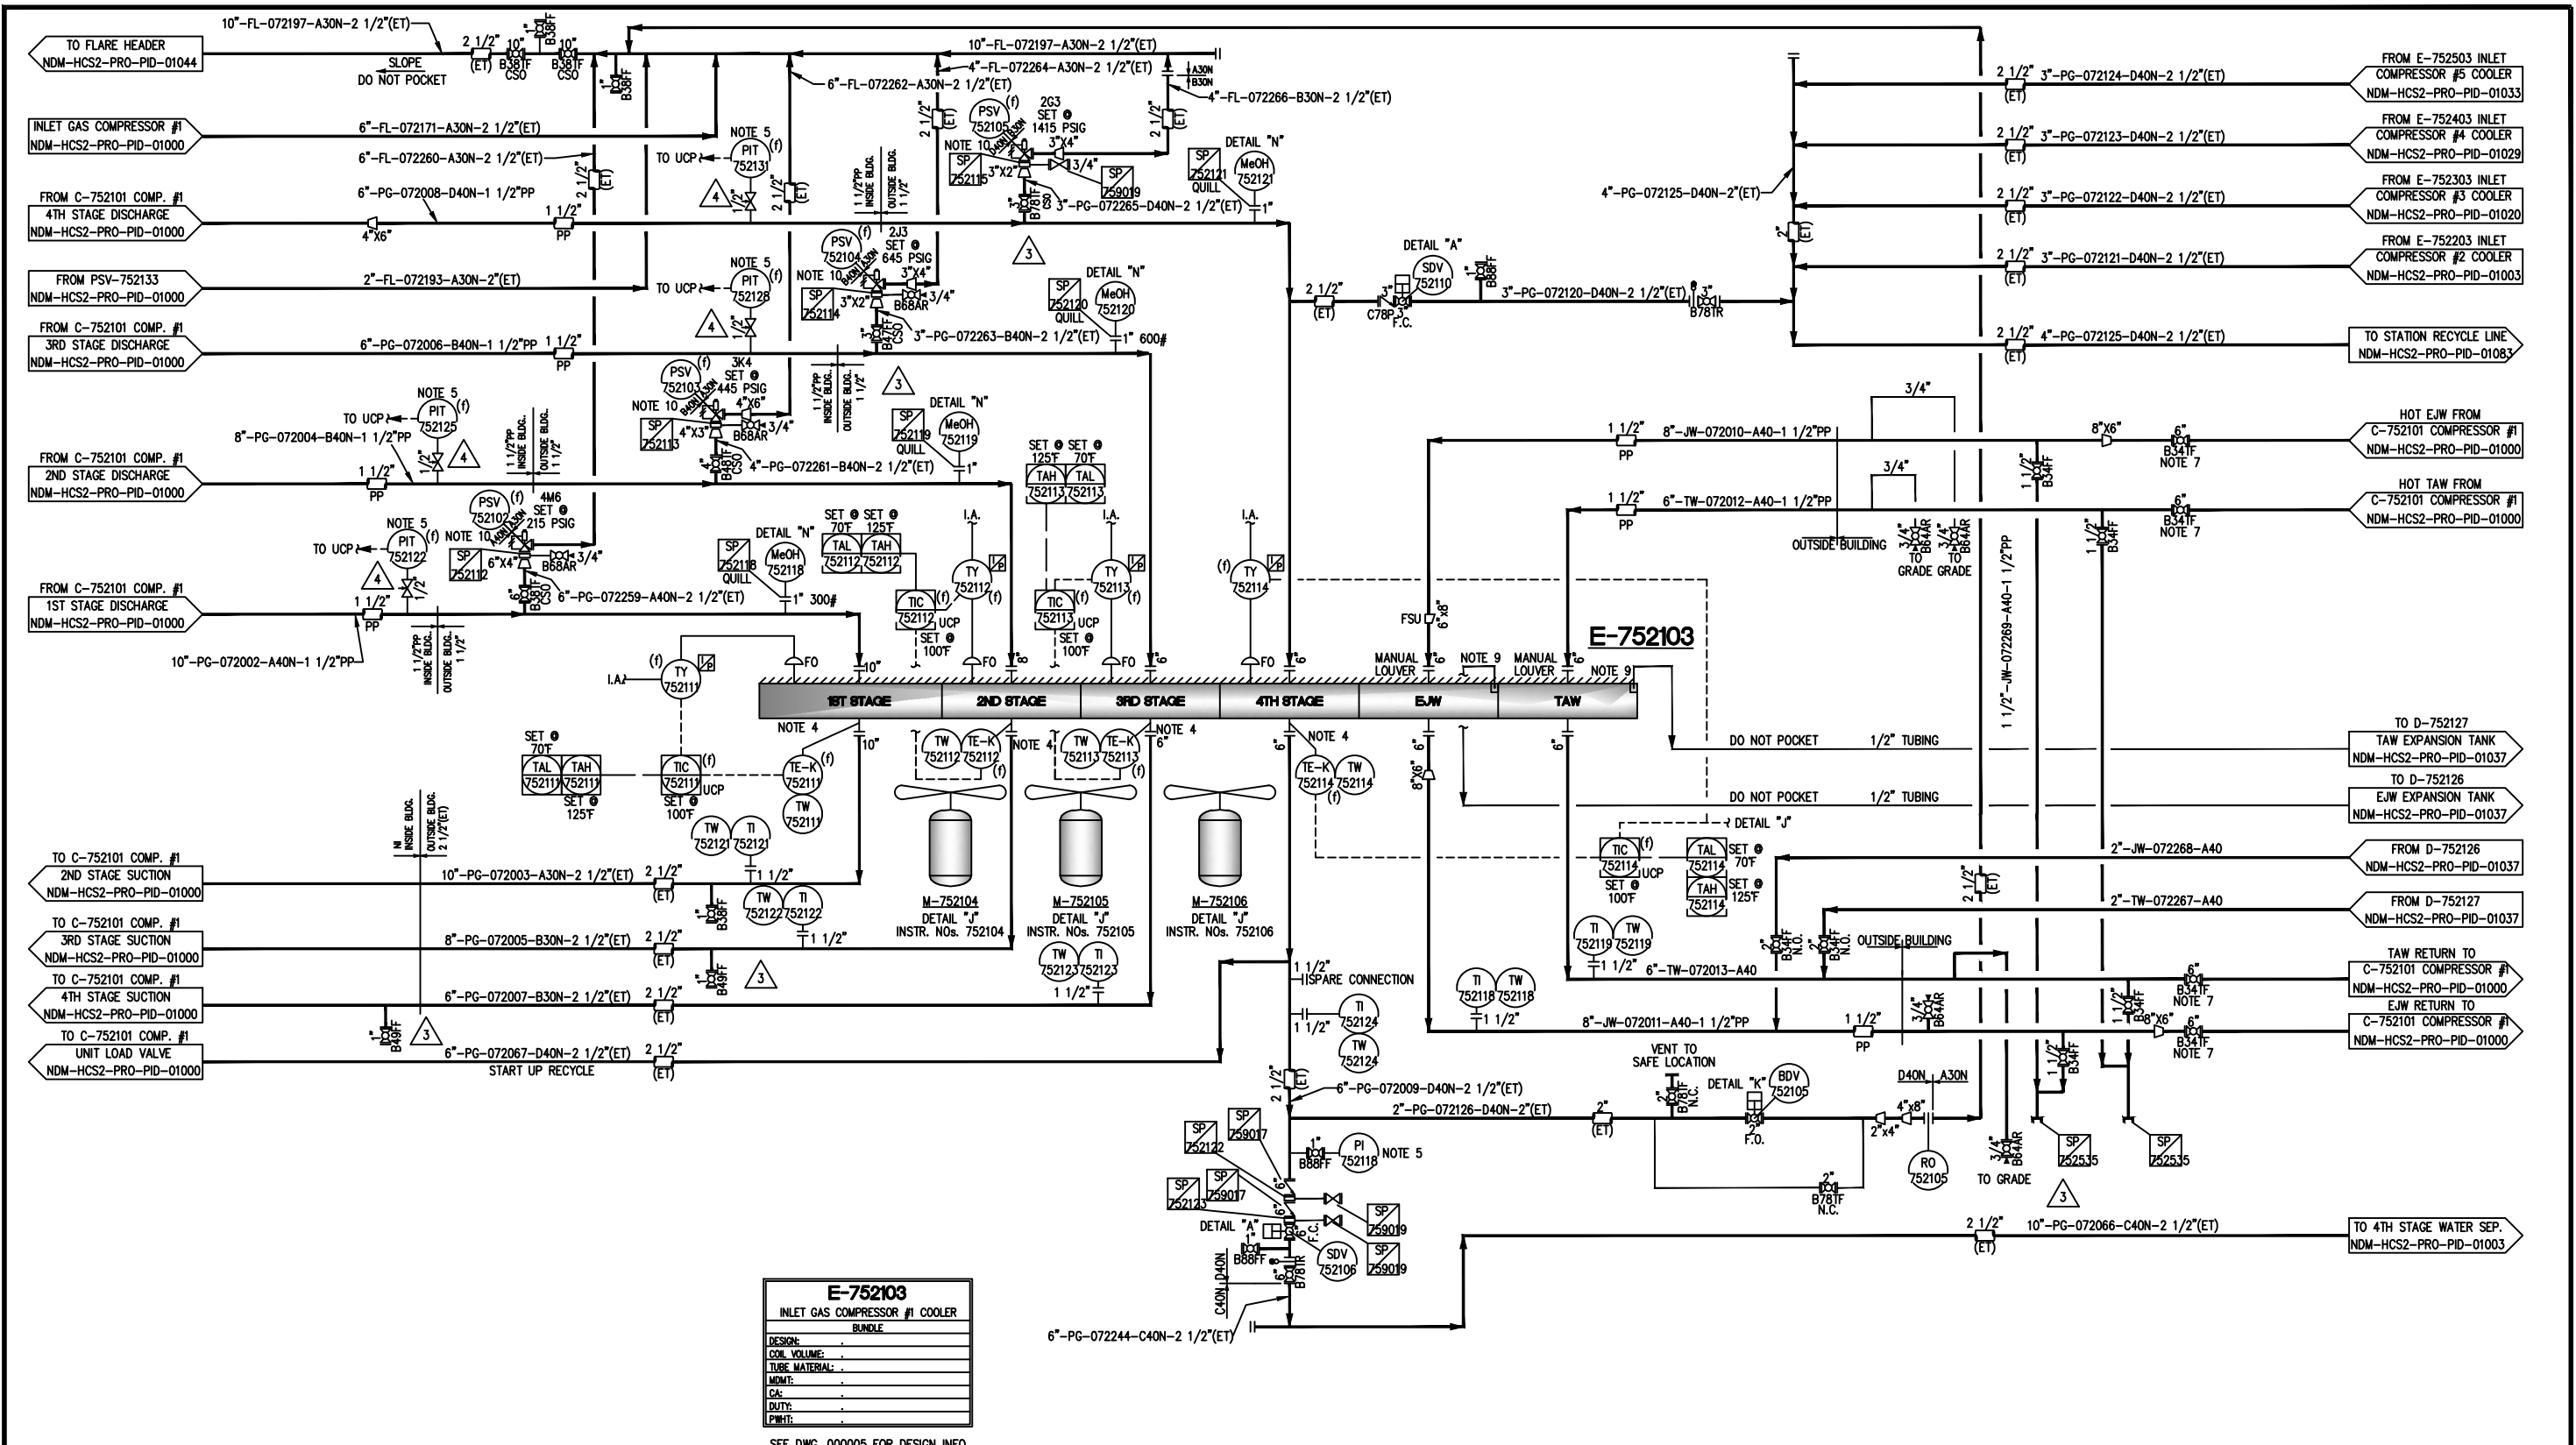

- NOTES:
1. PERSONNEL PROTECTION REQUIRED ON LINES OVER 150°F IN COMPRESSOR BUILDINGS. INSULATION FOR ATMOSPHERIC TEMPERATURE REQUIRED OUTSIDE OF BUILDINGS.
  2. DELETED.
  3. DELETED.
  4. TE-K AND TW WILL BE ON NOZZLE @ 45" WITH 3/4" NPT TAP FOR TW.
  5. SEE DETAIL "L" DWG. 000004 FOR CONFIGURATION.
  6. (f) FURNISHED BY VENDOR
  7. VALVE TO BE LOCATED NEAR COMPRESSOR.
  8. DELETED.
  9. HIGHEST TUBE PLUG.
  10. PSV IS HEAT TRACED AND INSULATED. BODY AND BONNET TO BE COVERED BY REMOVABLE INSULATION JACKET.

|           |          |                                        |  |  |  |  |  |          |            |             |  |
|-----------|----------|----------------------------------------|--|--|--|--|--|----------|------------|-------------|--|
|           |          |                                        |  |  |  |  |  |          |            |             |  |
|           |          |                                        |  |  |  |  |  |          |            |             |  |
|           |          |                                        |  |  |  |  |  |          |            |             |  |
| 5         | 02/08/16 | ASBUILT -- HESS DOCUMENT NUMBER UPDATE |  |  |  |  |  | SM       | JLG        | JLG         |  |
| 4         | 07/17/17 | REVISED PER MOC# GGS-04242017-01       |  |  |  |  |  | RKS      | KO         | KO          |  |
| 3         | 01/31/17 | FOR THE RECORD UPDATE                  |  |  |  |  |  | DS       | MS         | MS          |  |
| 2         | 04/11/16 | ISSUED FOR CONSTRUCTION                |  |  |  |  |  | LC       | DS         | MH          |  |
| 1         | 10/29/15 | ISSUED FOR CONSTRUCTION                |  |  |  |  |  | WXY      | RZJ        | DR          |  |
| 0         | 07/23/15 | ISSUED FOR CONSTRUCTION                |  |  |  |  |  | HR       | HQH        | DR          |  |
| NO        | DATE     | DESCRIPTION                            |  |  |  |  |  | DRAWN BY | CHECKED BY | APPROVED BY |  |
| REVISIONS |          |                                        |  |  |  |  |  |          |            |             |  |

|                                                                                       |                                                      |                                                                                                                           |                                                   |                                         |                             |
|---------------------------------------------------------------------------------------|------------------------------------------------------|---------------------------------------------------------------------------------------------------------------------------|---------------------------------------------------|-----------------------------------------|-----------------------------|
|  |                                                      | <b>HESS CORPORATION</b><br>EXPLORATION & PRODUCTION                                                                       |                                                   | <b>NORTH DAKOTA</b><br><b>MIDSTREAM</b> |                             |
|                                                                                       |                                                      | <b>HAWKEYE COMPRESSOR STATION</b><br><b>PIPING &amp; INSTRUMENTATION DIAGRAM</b><br><b>INLET GAS COMPRESSOR #1 COOLER</b> |                                                   |                                         |                             |
| DRAWN BY: <b>SJH</b>                                                                  |                                                      | DESIGN BY:                                                                                                                | CHECKED BY:                                       | APPRVD BY:                              | DATE: <b>6/10/14</b> SCALE: |
| SIZE<br><b>D</b>                                                                      | DRAWING No.<br><b>NDP-HCS-PRO-PID-072-STA-072002</b> |                                                                                                                           | HESS DRAWING No.<br><b>NDM-HCS2-PRO-PID-01001</b> |                                         | REV<br><b>5</b>             |