


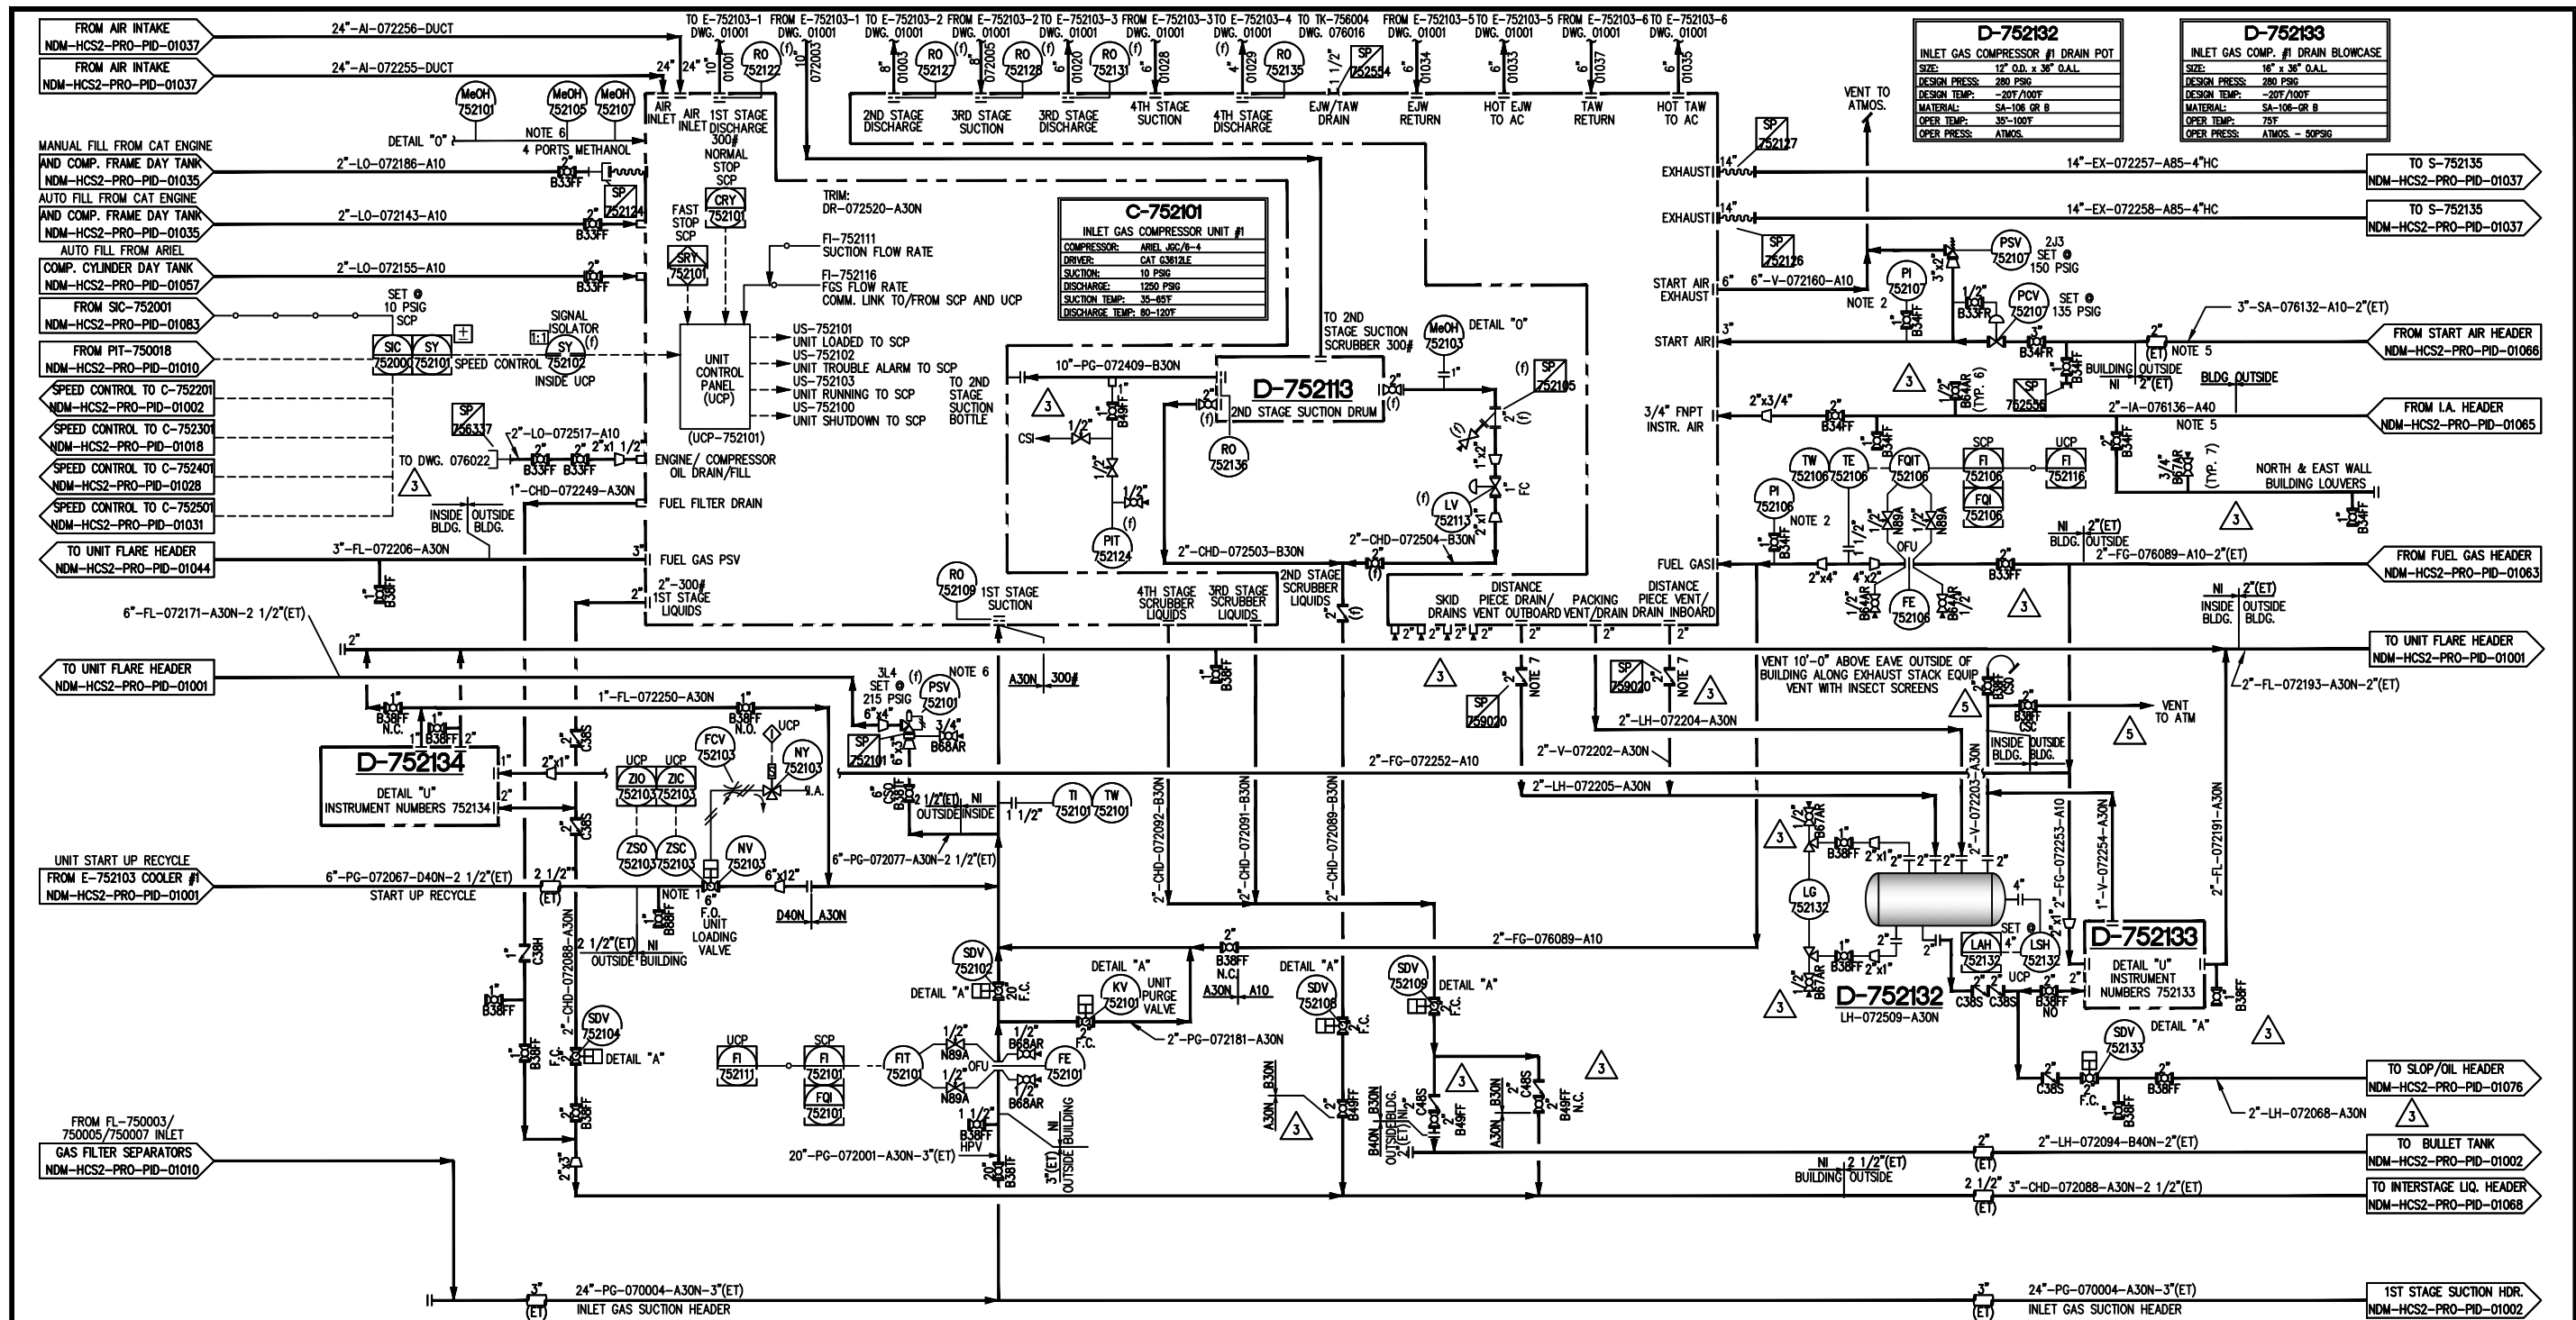

- NOTES:
1. DELETED.
 2. SEE DETAIL "L" FOR CONFIGURATION.
 3. INSULATION AND HEAT TRACING NOT REQUIRED IN COMPRESSOR BUILDING. LIQUID LINES WILL NOT BE HEAT TRACED AND INSULATED INSIDE OF BUILDING.
 4. DELETED.
 5. FUEL GAS AND STARTING AIR LINES TO BE INSULATED OUTSIDE WALL.
 6. PSV IS HEAT TRACED AND INSULATED BODY AND BONNET TO BE COVERED BY REMOVABLE INSULATION JACKET.
 7. SWING CHECK WITH LOW CRACKING PRESSURE (<10 PSI) PLACED IN HORIZONTAL ORIENTATION.
- (f) = FURNISHED BY VENDOR.

NO	DATE	DESCRIPTION	BY	CHKD	APP'D
5	09/22	REVISED PER MOC # MOC-2022-00282	AN	JC	JC
4	06/02/18	ASBUILT - HESS DOCUMENT NUMBER UPDATE	S.M	JLG	JLG
3	01/31/17	FOR THE RECORD UPDATE	DS	MS	MS
2	4/11/16	ISSUED FOR CONSTRUCTION	LC	DS	MH
1	10/29/15	ISSUED FOR CONSTRUCTION	WJX	TQY	DR
0	7/20/15	ISSUED FOR CONSTRUCTION	LY	RZJ	DR

HESS		HESS CORPORATION		NORTH DAKOTA	
		EXPLORATION & PRODUCTION		MIDSTREAM	
HAWKEYE COMPRESSOR STATION					
PIPING & INSTRUMENTATION DIAGRAM					
INLET GAS COMPRESSOR #1					
DRAWN BY: SHU		DESIGN BY:		CHECKED BY:	
DATE: 8/10/14		SCALE:		DATE: 8/10/14	
SIZE: INDP-HCS-PRO-PID-072-STA-072001		HESS DRAWING No.		REV 5	