
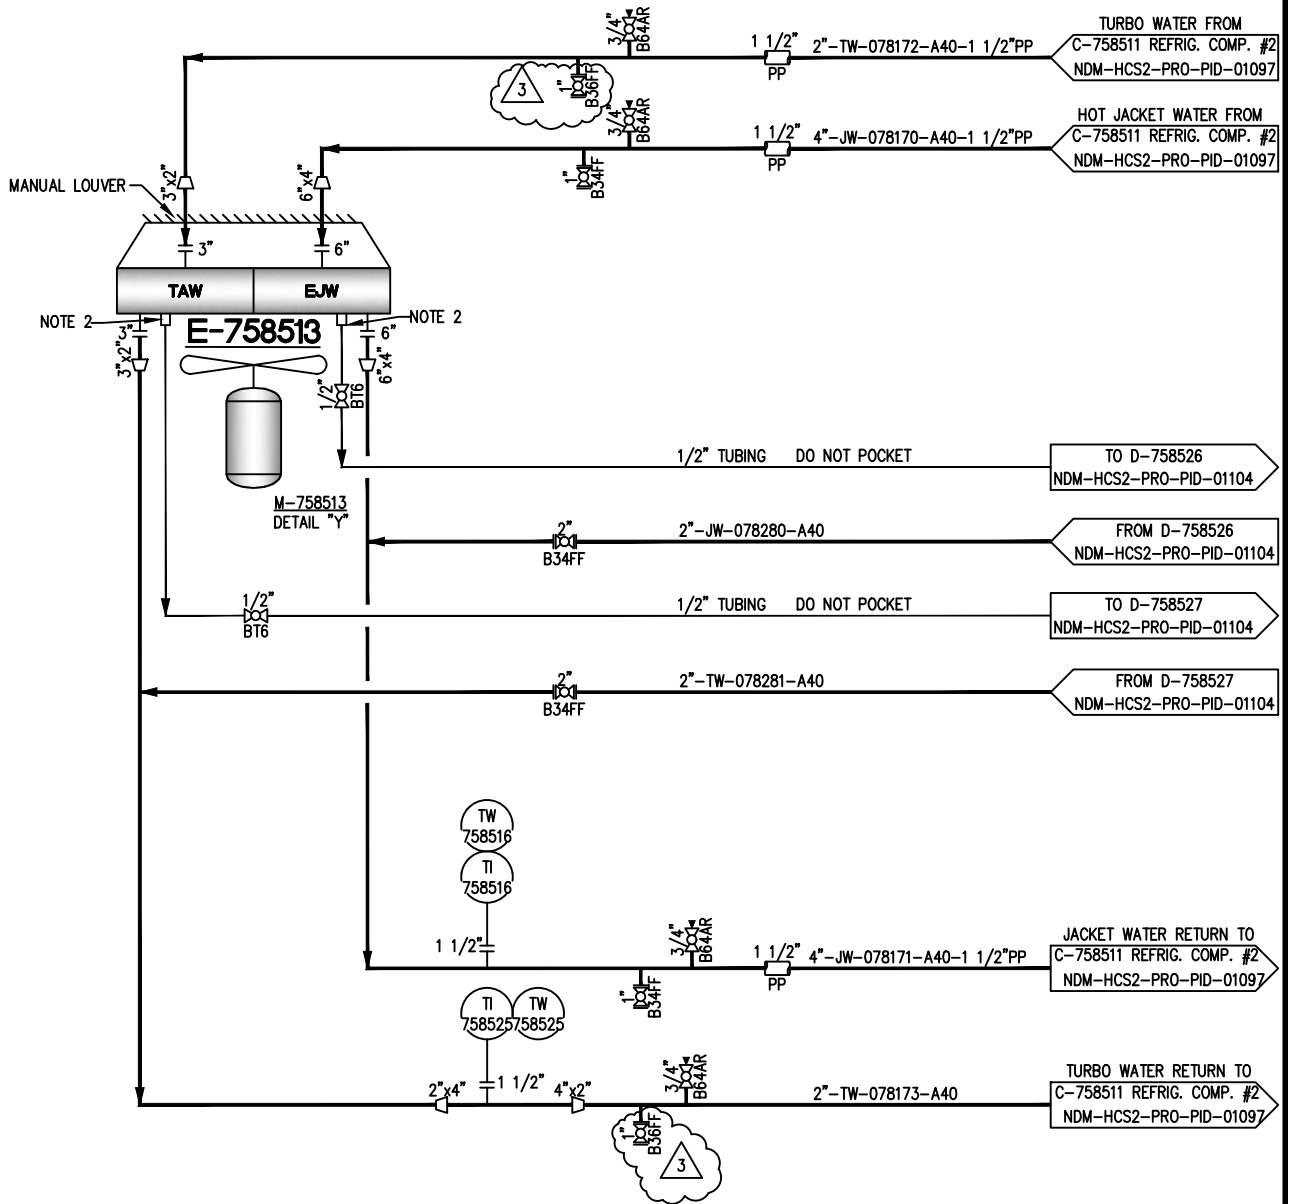


| E-758413                           |  |
|------------------------------------|--|
| REFRIGERATION COMPRESSOR #1 COOLER |  |
| BUNDLE                             |  |
| DESIGN:                            |  |
| COIL VOLUME:                       |  |
| TUBE MATERIAL:                     |  |
| MDMT:                              |  |
| CA:                                |  |
| DUTY:                              |  |
| PWHT:                              |  |

SEE DWG. 000005 FOR DATA

| E-758513                           |  |
|------------------------------------|--|
| REFRIGERATION COMPRESSOR #2 COOLER |  |
| BUNDLE                             |  |
| DESIGN:                            |  |
| COIL VOLUME:                       |  |
| TUBE MATERIAL:                     |  |
| MDMT:                              |  |
| CA:                                |  |
| DUTY:                              |  |
| PWHT:                              |  |

SEE DWG. 000005 FOR DATA

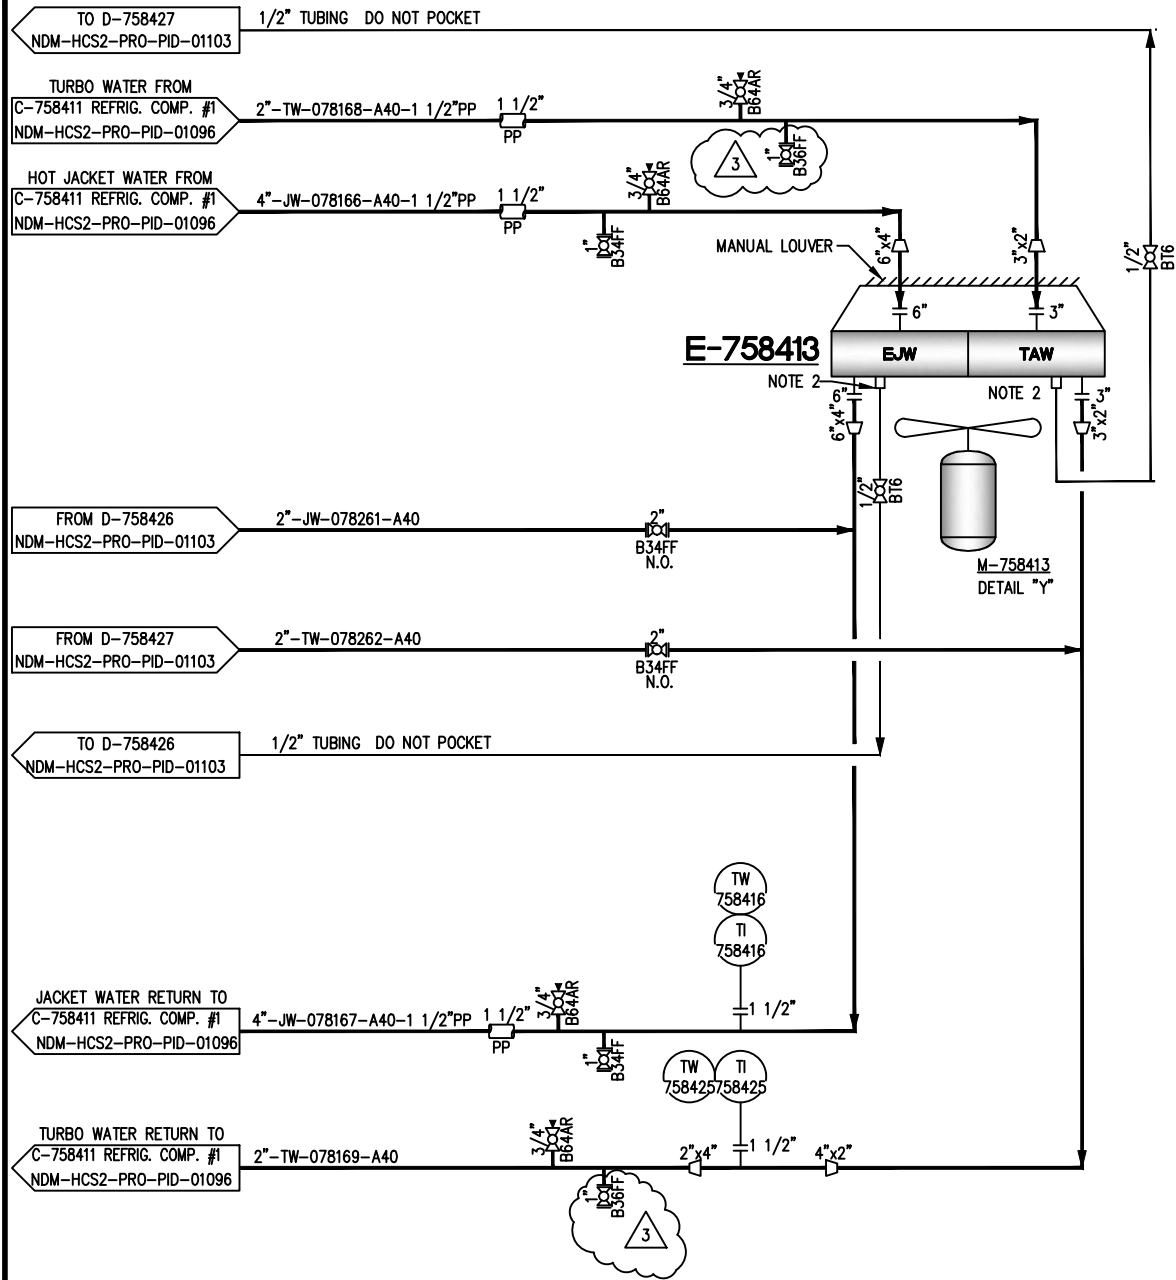

- NOTES:
1. DELETED.
  2. HIGHEST TUBE PLUG.

| NO | DATE     | DESCRIPTION                           | DRAWN BY | CHK'D BY | APP'D BY |
|----|----------|---------------------------------------|----------|----------|----------|
| 4  | 02/08/18 | ASBUILT - HESS DOCUMENT NUMBER UPDATE | S.M      | JLG      | JLG      |
| 3  | 02/15/17 | FOR THE RECORD UPDATE                 | DS       | MS       | MS       |
| 2  | 04/11/16 | ISSUED FOR CONSTRUCTION               | LC       | DS       | MH       |
| 1  | 10/29/15 | ISSUED FOR CONSTRUCTION               | YX       | GFQ      | DR       |
| 0  | 07/23/15 | ISSUED FOR CONSTRUCTION               | LJ       | RZJ      | DR       |

|                                                                                       |                                       |                                                     |             |                                         |                             |
|---------------------------------------------------------------------------------------|---------------------------------------|-----------------------------------------------------|-------------|-----------------------------------------|-----------------------------|
|  |                                       | <b>HESS CORPORATION</b><br>EXPLORATION & PRODUCTION |             | <b>NORTH DAKOTA</b><br><b>MIDSTREAM</b> |                             |
| <b>HAWKEYE COMPRESSOR STATION</b>                                                     |                                       |                                                     |             |                                         |                             |
| <b>PIPING &amp; INSTRUMENTATION DIAGRAM</b>                                           |                                       |                                                     |             |                                         |                             |
| <b>REFRIGERANT COMPRESSOR ENGINE COOLERS</b>                                          |                                       |                                                     |             |                                         |                             |
| DRAWN BY: <b>SJH</b>                                                                  |                                       | DESIGN BY:                                          | CHECKED BY: | APPRVD BY:                              | DATE: <b>6/11/14</b> SCALE: |
| SIZE                                                                                  | DRAWING No.                           | HESS DRAWING No.                                    |             |                                         | REV                         |
| <b>D</b>                                                                              | <b>NDP-HCS-PRO-PID-078-STA-078023</b> | <b>NDM-HCS2-PRO-PID-01102</b>                       |             |                                         | <b>4</b>                    |